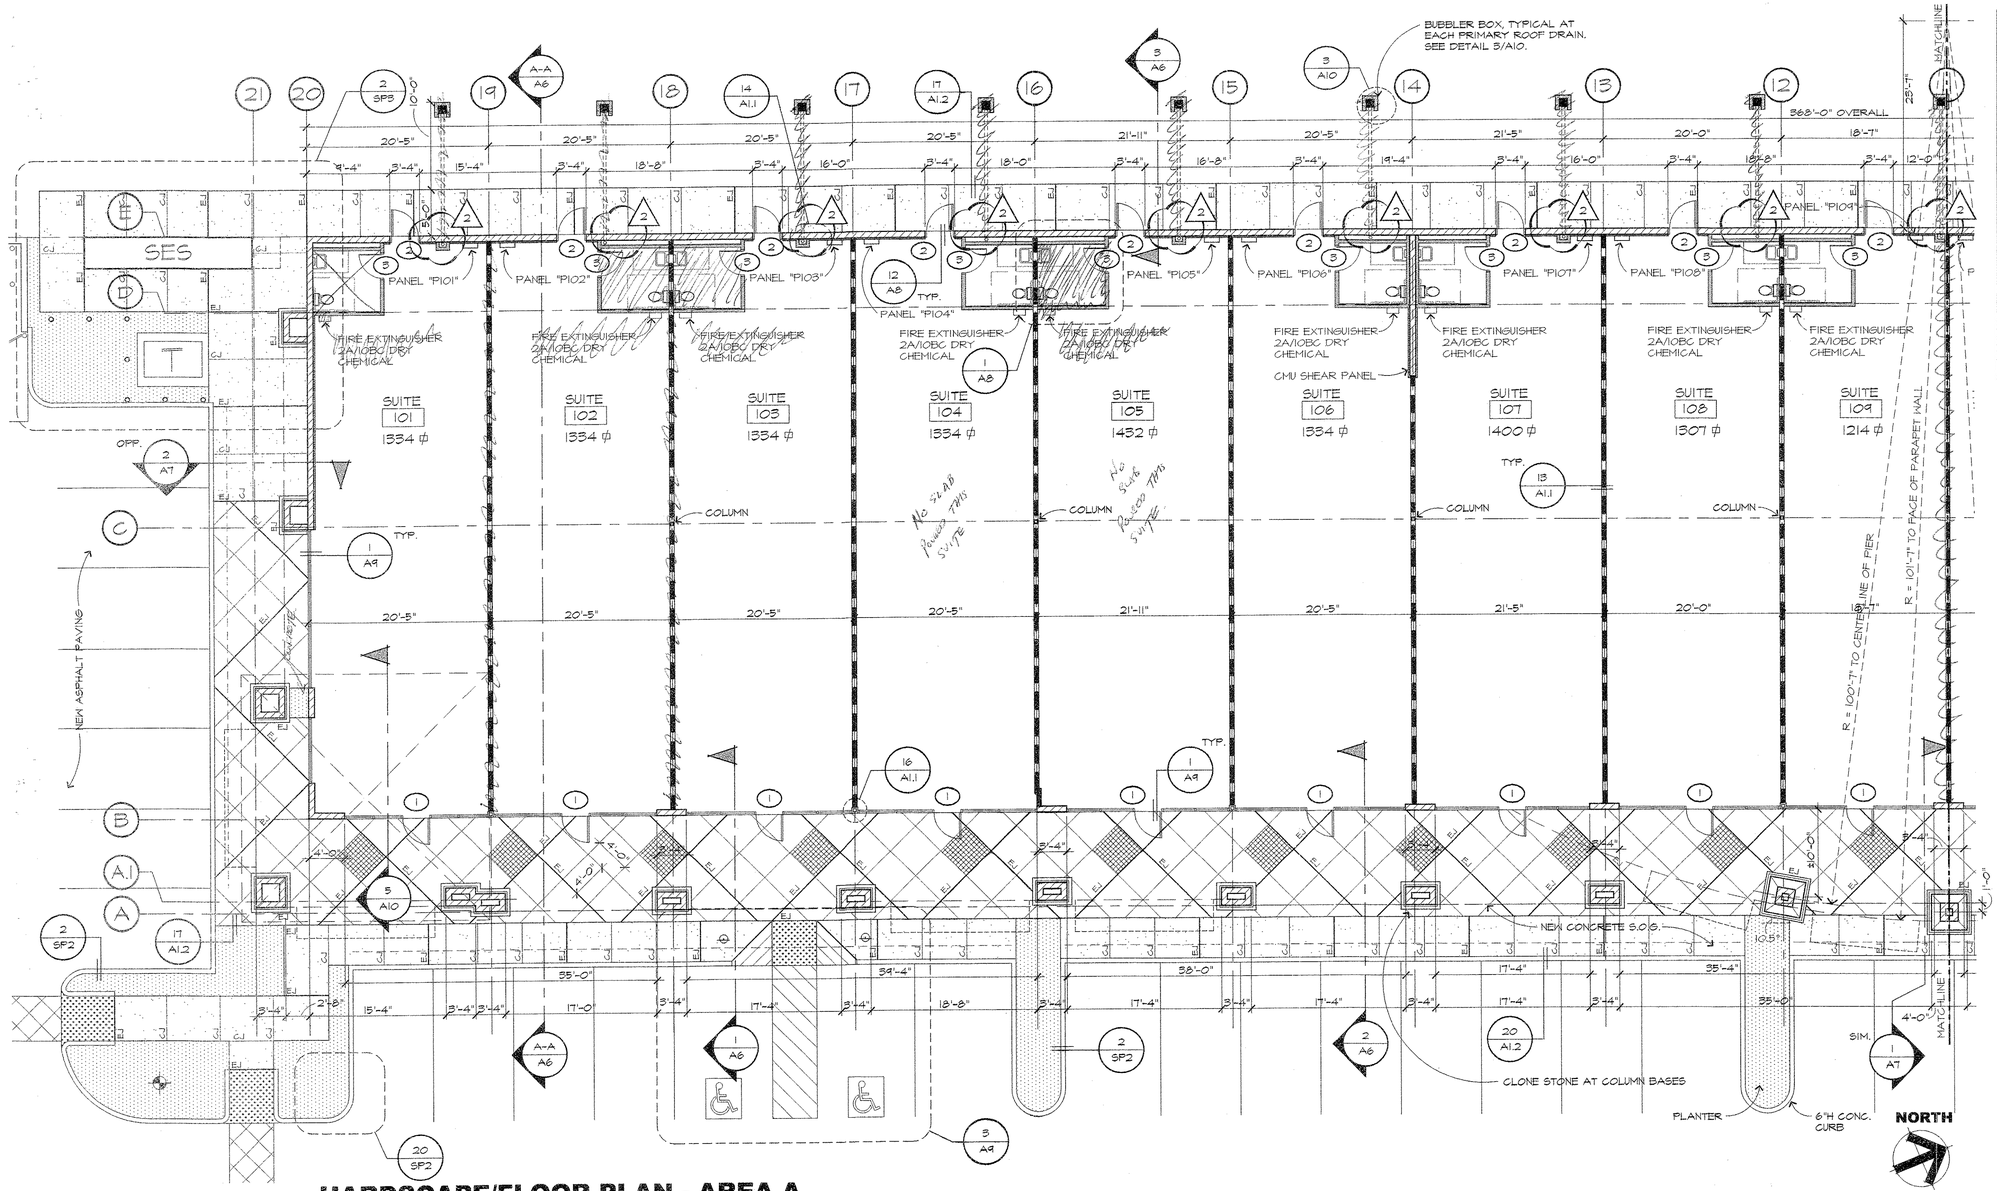

HARDSCAPE/FLOOR PLAN - AREA A

SCALE: 1/8" = 1'-0"

WALL LEGEND *

8"x8"x16" REINFORCED CMU WALL SEE BUILDING ELEVATIONS FOR ADDITIONAL INFORMATION

FULL HEIGHT PARTITION - 6" x 20 GA. METAL STUDS AT 24" O.C. TO B.O. ROOF DECK WITH 5/8" TYPE 'X' GYP. BRD. TO B.O. ROOF DECK. PROVIDE FOAM GASKETS AT TOP AND BOTTOM TRACKS TYPICAL. WITH HORIZONTAL BLOCKING AT 10'-0" O.C. MAXIMUM.

FULL HEIGHT PARTITION - 3 5/8" x 20 GA. METAL STUDS AT 24" O.C. WITH 5/8" GYP. BRD. BOTH SIDES TO 6" ABOVE CEILING LINE (NOTE: 5/8" W.R. TYP. X GYP. BRD. ON INSIDE OF TOILET ROOM), WITH R-13 INSUL. PROVIDE FOAM GASKETS AT TOP AND BOTTOM TRACK, TYPICAL.

FURRING - 1 1/2" x 22 GA. METAL Z-STUDS AT 24"O.C. WITH 5/8" TYPE 'X' GYP. BRD. ONE SIDE TO 6" ABOVE CEILING LINE WITH 1 1/2" RIGID INSULATION MECHANICALLY FASTENED TO CMU.

* ALL INTERIOR WALLS TO BE SANDED, TAPED, READY FOR FINISH (EXCEPT RESTROOM WALLS) SEE 3/A8 FOR RESTROOM ELEVATIONS

SYMBOL LEGEND

DETAIL REFERENCE
DETAIL SYMBOL
SHEET NUMBER (-) INDICATES SAME SHEET

SECTION REFERENCE
SECTION SYMBOL
SHEET NUMBER (-) INDICATES SAME SHEET

ELEVATION NUMBER
WALLS SHOWN IN ELEVATION
SHEET NUMBER (-) INDICATES SAME SHEET

ELEVATION NUMBER
ELEVATION SYMBOL
SHEET NUMBER (-) INDICATES SAME SHEET

ROOM NAME RM # — ROOM NUMBER

DOOR NUMBER

FINISH NOTE

HARDSCAPE LEGEND:

E.J. EXPANSION JOINT

C.J. CONTROL JOINT

MEDIUM BROOM FINISH STANDARD GREY COLORED CONCRETE. SLOPE TO DRAIN AWAY FROM BUILDING MIN. OF 1% and NOT TO EXCEED 2% MAX. PROVIDE CONTROL and EXPANSION JOINTS AS NOTED ON PLAN.

SALT FINISH STANDARD GREY COLORED CONCRETE WITH DIAGONAL SCORING AS SHOWN. SLOPE TO DRAIN AWAY FROM BUILDING MIN. OF 1% and NOT TO EXCEED 2% MAX. PROVIDE CONTROL and EXPANSION JOINTS AS NOTED ON PLAN.

MEDIUM SANDBLASTED FINISH STANDARD GREY COLORED CONCRETE WITH DIAGONAL SCORING AS SHOWN. SLOPE TO DRAIN AWAY FROM BUILDING MIN. OF 1% and NOT TO EXCEED 2% MAX.

ASBUILT
WESPAC CONSTRUCTION, INC.

Revisions
CITY OF MARICOPA
Building Safety Dept.
Approved ☑ As Noted ☑
Date 1-3-5
Need to revise sheet P1.1 to show changes from ⚠ 3 dated 11-15-05 Arch. plans and Revised Utility plan sheets C-5, C-6 dated 11-11-05

City of Maricopa – Building Safety
Date: 2005-12-12 00:00:00 Project # 5397
Reviews x1st □2nd □3rd □ Approved
Project Desc. The Shops at Maricopa Fiesta
Revision: 1
A__S__P__M__E__D__GD__F__

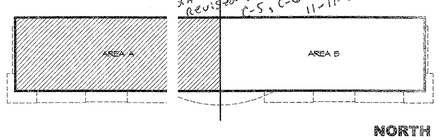

KEYPLAN

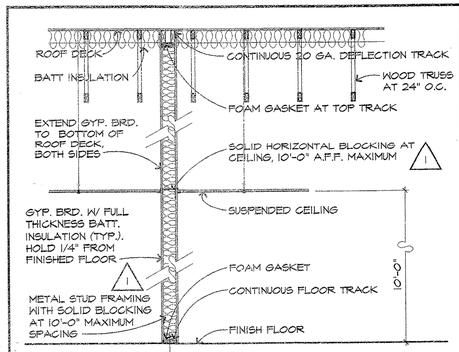

13 DEMISING WALL

SCALE: 3/8" = 1'-0"

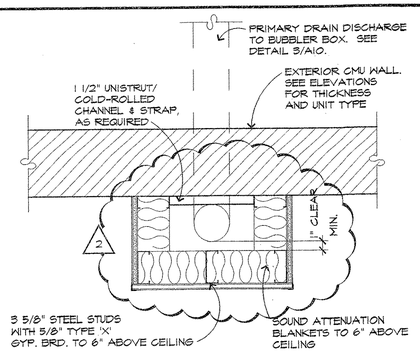

14 RDL CHASE

SCALE: 1 1/2" = 1'-0"

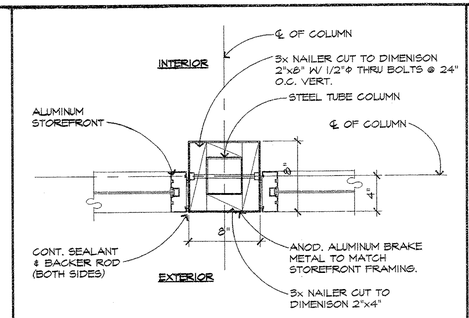

15 COLUMN AT STORE FRONT

SCALE: 1 1/2" = 1'-0"

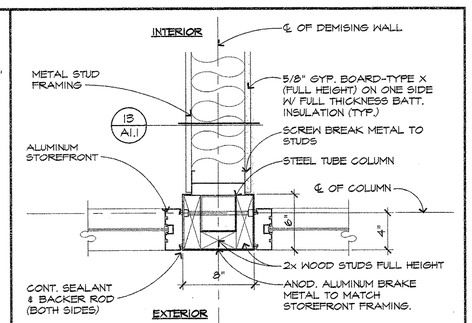

16 COLUMN AT DIMISING WALL

SCALE: 1 1/2" = 1'-0"

RBK Architects And Associates, Inc.
2233 East Thomas Road
Phoenix, Az. 85016-5474
(602) 955-3900 Phone
(602) 955-0498 Fax
www.rbaa.com

REGISTERED ARCHITECT CERTIFICATE NO. HARVEY G. UNTI 11571 Date Signed 12-12-05 ARIZONA, U.S.A.


10-14-05	CITY REVISIONS	
11-15-05	OWNER VE CHANGES	

HARDSCAPE/FLOOR PLAN AREA A

OWNER AT THE OFFICES OF MARICOPA SHOPS, S.L.C. 2233 EAST THOMAS ROAD, SUITE 207 PHOENIX, ARIZONA 85016 (602) 955-3900

OR AS DESIGNATED AGENT SHALL PROVIDE A WRITTEN DESCRIPTION OF PROCEDURE

MARICOPA FIESTA PHASE 4
MARICOPA SHOPS, L.L.C.

SWC SMITH-ENKE ROAD AND JOHN WAYNE PARKWAY (S.R. 347)
MARICOPA, ARIZONA

design KF
drawn CAJ
check HU

sheet A1.1
of
job 05050.00